



PROCUREMENT SERVICES

CITY OF SURREY, SURREY CITY HALL
13450 – 104 Avenue, Surrey, B.C., V3T 1V8
Tel: 604-590-7274
E-mail: purchasing@surrey.ca

ADDENDUM No. 2

INVITATION TO TENDER No.: 1220-020-2024-004

TITLE: Modular Daycare Addition at Don Christian Rec Centre

ADDENDUM ISSUE DATE: May 8, 2024

REVISED CLOSING DATE AND TIME: ON OR BEFORE THE FOLLOWING DATE AND TIME (THE "CLOSING TIME"):

TIME: 11:00 a.m. (LOCAL TIME)

May 17, 2024

INFORMATION FOR TENDERERS

Tenderers are advised that Addendum No. 2 to 1220-020-2024-004 is hereby issued by the City. This addendum shall form part of the contract documents and is to be read, interpreted and coordinated with all other parts. The following information is provided to answer questions raised by Tenderers for the above-named project, to the extent referenced and shall become a part thereof. No consideration will be allowed for extras due to the Tenderers or any sub-contractor not being familiar with this addendum. This Addendum No. 2 contains three (3) pages.

REVISED CLOSING TIME:

Delete Section 2.1 in its entirety and substitute with Section 2.1 below:

2.1 Closing Time and Address for Proposal Delivery

The Proponent should submit the Proposal **electronically** in a single pdf file which must be delivered by email at: purchasing@surrey.ca

on or before the following date and time

Time: 3:00 p.m., local time

Date: May 17, 2024

(the "Closing Time").

Confirmation of receipt of email will be issued. Proposals that cannot be opened or viewed may be rejected. A Proponent bears all risk that the City's receiving computer equipment functions properly so that the Proposal is received by the Closing Time.

Note: The maximum file size the City can receive is 10Mb. If sending large email attachments, Proponents should phone [604-590-7274] to confirm receipt.

QUESTIONS AND ANSWERS:


- Q1.** Referring to structural drawing S2, please clarify the missing detail for the section marked 'C' between grid 27-28.
- A1.** Please see revised plan and sections as per Attachment 1 attached to the end of this Addendum No. 2.
- Q2.** Please provide specs of Sheet Vinyl floor (Manufacture, size, color, type) at new Activity rooms, washrooms, storage.
- A2.** The finishes for the modular portion of the building is design-build based on the schematic information provided in the architectural drawings.
- Q3.** Please confirm Sheet vinyl at washroom (RM005, RM006) will be flash covered 150mm high.
- A3.** The finishes for the modular portion of the building is design-build based on the schematic information provided in the architectural drawings.
- Q4.** If wall base is rubber base, please provide spec of rubber base (manufacture, size, color, type)?
- A4.** The finishes for the modular portion of the building is design-build based on the schematic information provided in the architectural drawings.
- Q5.** RM008 and RM009 have steps and landing, please provide spec of tactile (manufacture, type, color).
- A5.** The finishes for the modular portion of the building is design-build based on the schematic information provided in the architectural drawings.
- Q6.** RM002 (Activity room) has a kitchenette. If we need to price backsplash tile, please provide spec of tile (manufacture, type, size, color).
- A6.** The finishes for the modular portion of the building is design-build based on the schematic information provided in the architectural drawings.
- Q7.** Please confirm wall tile will not be used at washroom wall (RM005, RM006).

A7. The finishes for the modular portion of the building is design-build based on the schematic information provided in the architectural drawings.

All Addenda will become part of the Contract Documents.

- END OF ADDENDUM -

Attachment 1

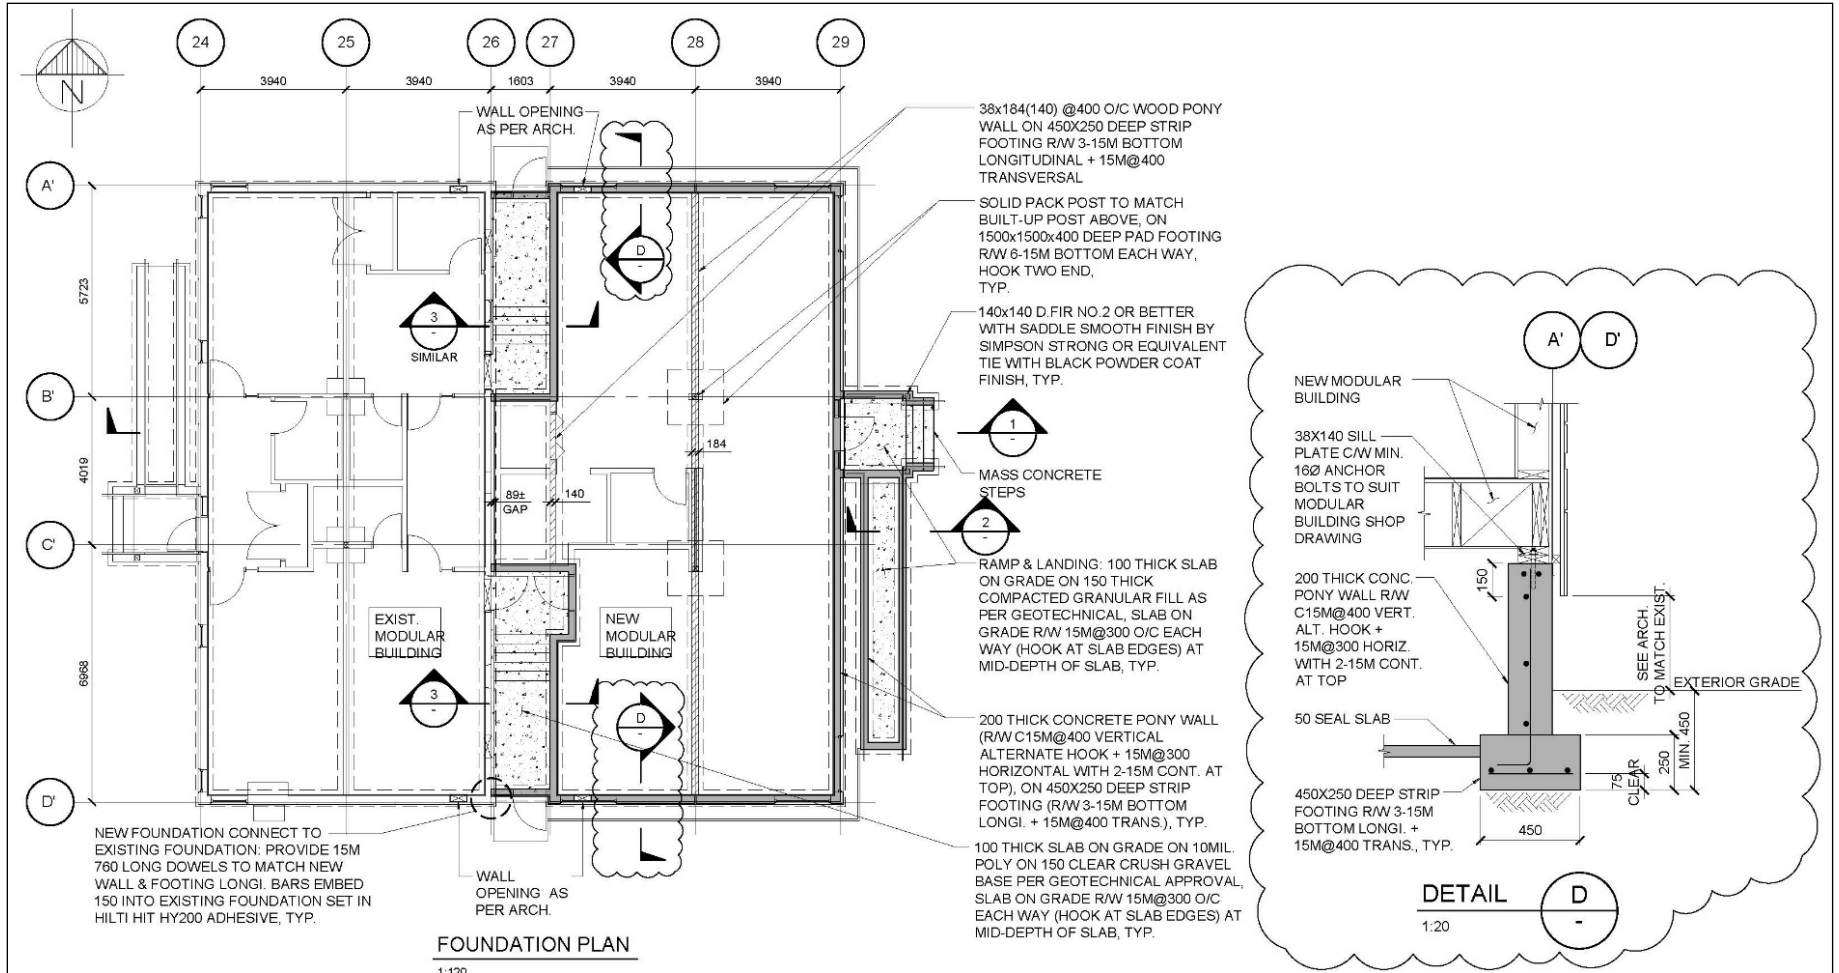

<p>CWMM CONSULTING ENGINEERS LTD. 1482 West 7th Ave. Vancouver, B.C. Canada, V6H 1C1 Tel: (604) 731-6554 Fax: (604) 736-6110 engineers@cwmm.com EGBC Permit to Practice #1000918</p>	<p>FOUNDATION PLAN, SECTION</p>		<p>SCALE: AS SHOWN</p>	<p>PROJ. NO.: 13293</p>
	<p>TITLE:</p>	<p>DATE: 2024.MAY.06</p>		<p>DWG. NO.:</p>
	<p>REFERENCE DRAWING:</p>	<p>DESIGNED: LL</p>		<p>ADD-01</p>
	<p>PROJECT: DON CHRISTIAN DAYCARE 6224 184 STREET, SURREY, BC</p>	<p>DRAWN: SK</p>	<p>CHECKED: -</p>	